
BILL OF MATERIAL					
ITEM	DWG. NO.	QTY.	MATERIAL	DESCRIPTION	WEIGHT

SIZES OF MATERIAL GIVEN DO NOT INCLUDE STOCK ALLOWANCE FOR MACHINING AND CUTTING OFF EXCEPT AS NOTED. THE SIZE SPECIFIED THE MATERIAL REQUIRED FOR ONE PIECE ONLY. QUANTITIES NOTED ARE THE TOTAL NUMBER REQUIRED.

See Ind. Detail For Materials Req'd For Const.

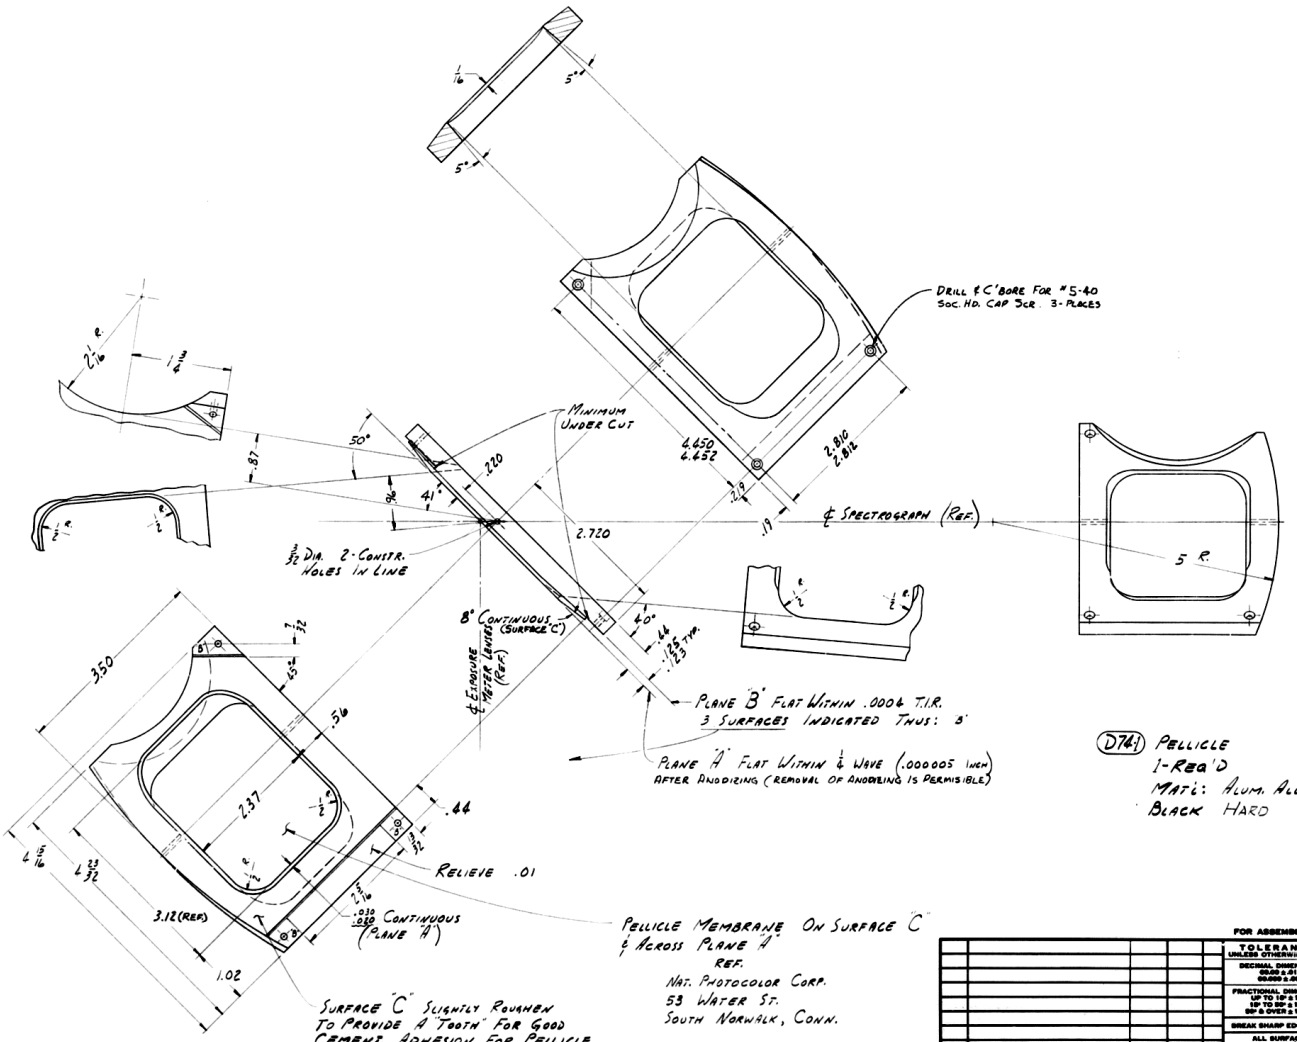

D74-1 Pellicle
1-Req'd
Mat'l: Alum. Alloy #2024-T351
Black Hard Anodize

For Assembly See 2028.01-E15

Ref. File 2090

TOLERANCES UNLESS OTHERWISE NOTED
DECIMAL DIMENSIONS .00 ± .010 .000 ± .005
FRACTIONAL DIMENSIONS UP TO 10" ± 1/64 10" TO 20" ± 1/32 20" & OVER ± 1/16
BREAK SHARP EDGES 1/64
ALL SURFACES TO HAVE 125 FINISH UNLESS OTHERWISE NOTED.

QUANT.	PRINT RECORD	DATE	NO.	REVISION	ECR	DATE	BY
			A	REV. AS BUILT	0301	7-10-68	CHN

KITT PEAK NATIONAL OBSERVATORY
OPERATED BY THE ASSOCIATION OF UNIVERSITIES FOR RESEARCH IN ASTRONOMY, INC. UNDER CONTRACT WITH NATIONAL SCIENCE FOUNDATION

84" Tel. -- Cassegrain Spectrograph

NAME - Detail - Exposure Meter Pellicle

SCALE Full

PRINT ISSUED

DESIGNED BY	DRAWN BY	TRACED BY	CHECKED BY	APPROVED BY	DATE
7-27-67	7-26-68				7-26-68
8-23-67	10-24-67				10-24-67
11-6-67	11-16-67				11-16-67

DRAWING NUMBER 2028.01-D 74 REV. A