
BILL OF MATERIAL					SIZES OF MATERIAL NOTED DO NOT INCLUDE STOCK ALLOWANCE FOR MACHINING AND CUTTING OFF EXCEPT AS NOTED. THE SIZE SPECIFIES THE MATERIAL REQUIRED FOR ONE PIECE ONLY. QUANTITIES NOTED ARE THE TOTAL NUMBER REQUIRED.	
ITEM	DWG. NO.	QTY.	MATERIAL		DESCRIPTION	WEIGHT

SEE INDIVIDUAL DETAIL OF PARTS FOR MATERIAL REQUIRED FOR FABRICATION

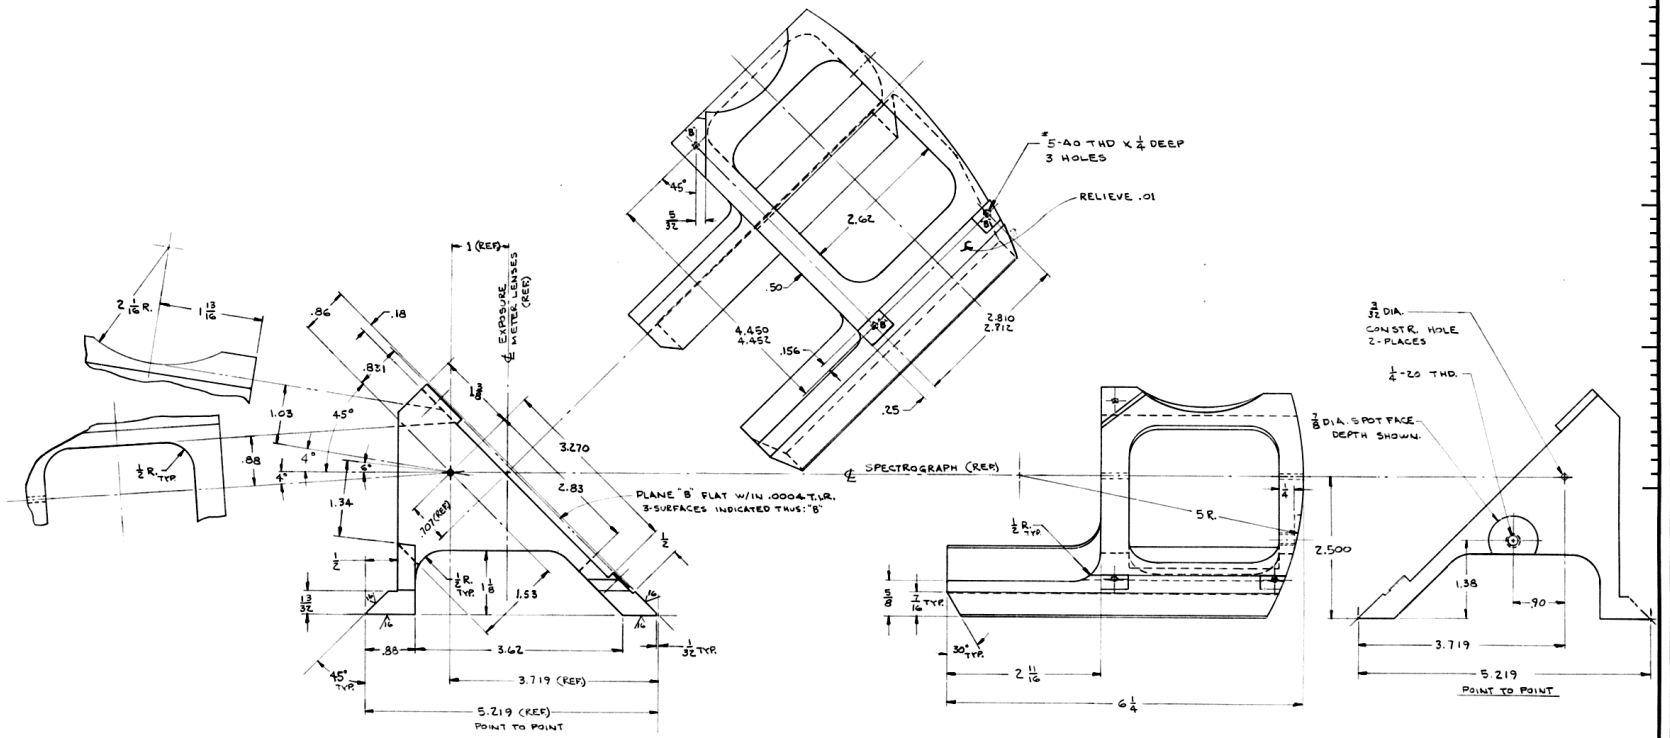

(D75-1) SLIDE
1 REQ'D - MAT'L: ALUM. ALLOY #2024-T4
FINISH: HARD ANODIZE (BLACK)

REF. FILE 2090

FOR ASSEMBLY SEE 2028.01-E15

QUANT.	PRINT RECORD	DATE	NO.	REVISION		DATE	BY
			A	REVAS BUILT	0801	7-10-68	CMW
					ECR		

TOLERANCES UNLESS OTHERWISE NOTED
DECIMAL DIMENSIONS
00.00 ± .010
00.000 ± .005
FRACTIONAL DIMENSIONS
UP TO 10" ± 1/64
10" TO 20" ± 1/32
20" & OVER ± 1/16
BREAK SHARP EDGES 1/64
ALL MACHINED SURFACES TO HAVE 125 FINISH UNLESS OTHERWISE NOTED.

KITT PEAK NATIONAL OBSERVATORY
OPERATED BY THE ASSOCIATION OF UNIVERSITIES FOR RESEARCH IN ASTRONOMY, INC. UNDER CONTRACT WITH NATIONAL SCIENCE FOUNDATION

84" TEL. CASSEGRAIN SPECTROGRAPH

NAME: -DETAIL- EXPOSURE METER SLIDE

SCALE FULL
PRINT ISSUED

DESIGNED BY	DATE	DRAWN BY	DATE	DRAWING NUMBER	REV.
[illegible]	7-10-68	[illegible]	7-8-68	2028.01-D 75	A
CHECKED BY	DATE	APPROVED BY	DATE		
[illegible]	7-11-68	[illegible]	7-12-68		
ENGINEER IN CHARGE	DATE	PROJECT ENGINEER	DATE		
[illegible]	7-12-68	[illegible]	7-12-68		

TUCSON TOOL DESIGN

8-63 DIETERICH-POST CLEARPRINT 3009